


Approvals
 Pursuant to Sec 314 Local Government Act 1974, hereby certify that the building shown hereon was constructed before 1st April 1979 and was provided with such so/equivalents against fire and means of escape in case of fire as were required by the bylaws of the Hamilton City Council applying as at the date of this certificate.
 Dated this 17th day of February 1991

[Signature]
 City Secretary/Assoc. Town Clerk

I hereby certify that the building shown hereon is erected in the position shown and is within the boundaries of Lot 16 DP 11219, C.T. 722/28.

[Signature]
 Registered Surveyor

Approved by owners:
[Signature]
 Joseph J. G. G. G.

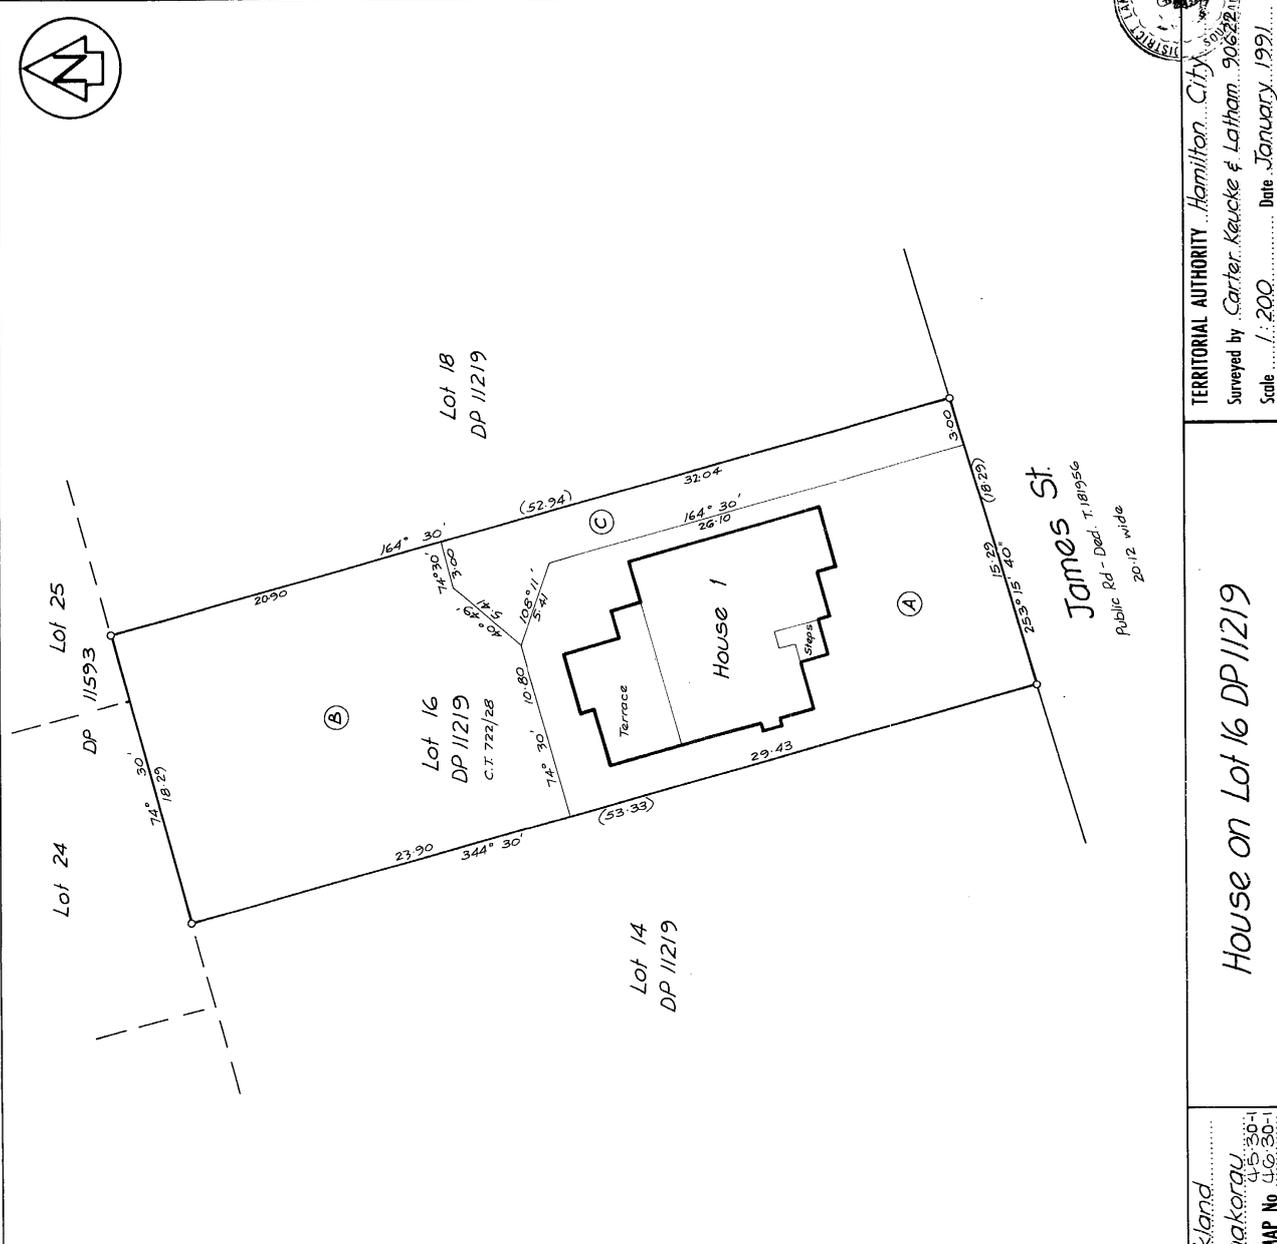

Total Area 972 m²

Comprised in All C.T. 722/28

I, John Jeffrey Carter, Registered Surveyor and holder of an annual practising certificate for who may act as a registered surveyor pursuant to section 25 of the Survey Act 1988 hereby certify that this plan has been made from surveys executed by me or under my directions, that both plan and survey are correct and have been made in accordance with the Survey Regulations 1982 and any regulations made in substitution therefor. Dated at Hamilton this 17th day of February 1991

Signature *[Signature]*
 L.T. Surveyor

Field Book
 Reference Plans DP 11219
 Examined *[Signature]* Correct

Approved for leasing purposes only
 19. 18. 1991
 L.T. Surveyor

Proposed this 14th day of March 1991.
 West District Land Registrar

Received 19.2.91
 D P S 59250

TERRITORIAL AUTHORITY Hamilton City
 Surveyed by Carter, Keuicke & Latham 20/6/82
 Scale 1:200 Date January 1991

LAND DISTRICT South Auckland
 SURVEY BLK. & DIST. XIV. Komakorua 4536-1
 NZMS 261 SHT 814 RECORD MAP No. 4630-1
 (Hamilton)

W.A. ROBERTSON, SURVEYOR GENERAL, DEPARTMENT OF SURVEY AND LAND INFORMATION, NEW ZEALAND

